
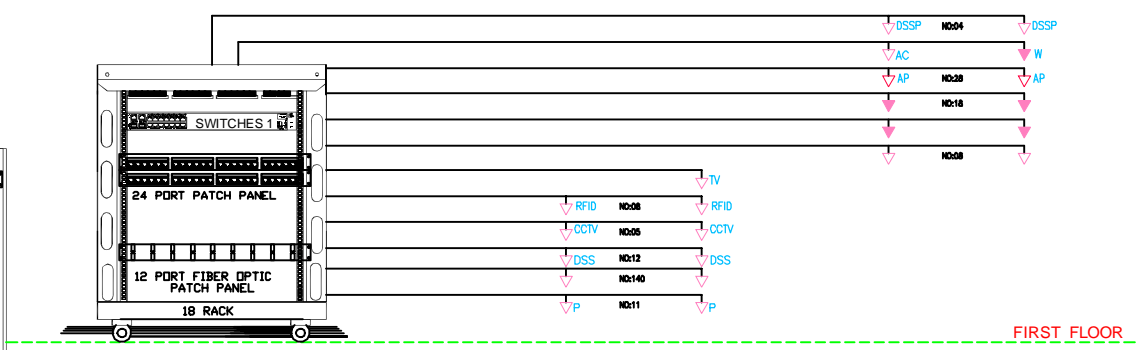





SECOND FLOOR

SECOND FLOOR

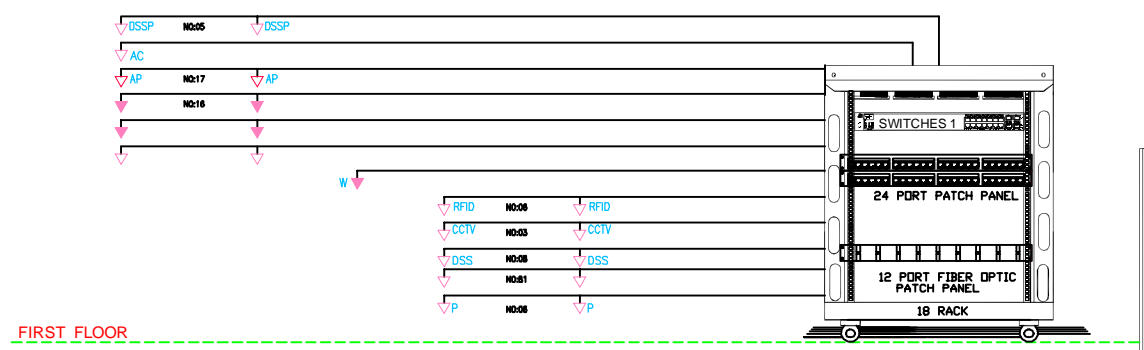


FIRST FLOOR

FIRST FLOOR

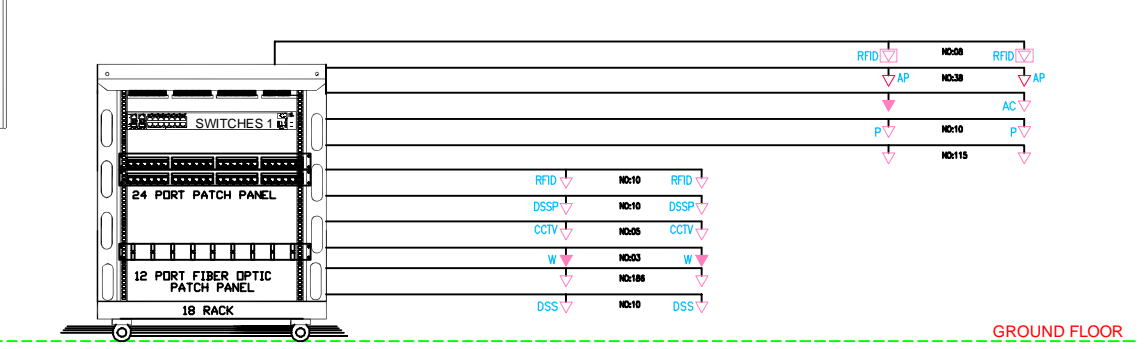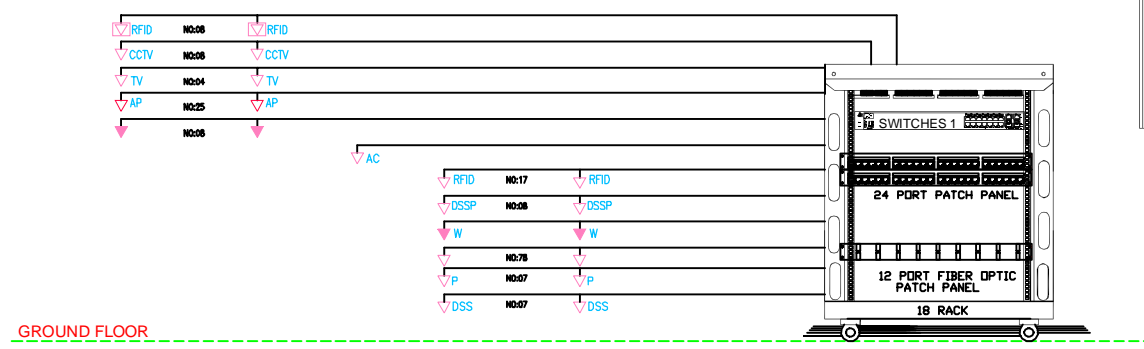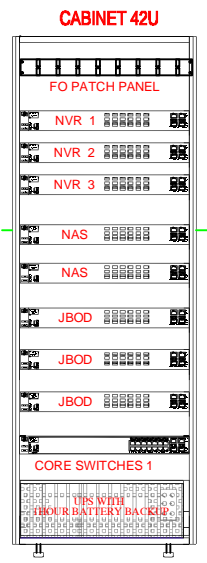

GROUND FLOOR

GROUND FLOOR

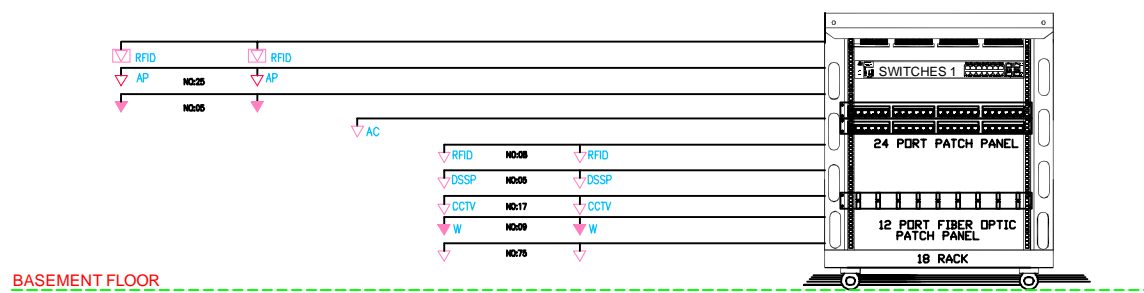

BASEMENT FLOOR

SCHEMATIC DIAGRAM

Revision:	REVISED AS PER MCI COMMENTS	DDMMYY:
Revision:	REVISED AS PER MCI COMMENTS	DDMMYY:
Project:	As Constructed	Site: m/s:
The Owner:		
CCTV Contractor:		
Drawing Title:		
Drawn By:	Checked By:	Scale:
Shubh P.		
Title:	Scale:	Drawing Number: